

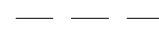


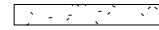


AS BUILT PLAN LEGEND


-  EXISTING CONCRETE WALL TO REMAIN
-  EXISTING FRAMED WALL TO REMAIN
-  ELEMENTS TO BE REMOVED
-  HIDDEN ELEMENT
-  OVERHEAD ELEMENT

AS BUILT PLAN NOTES

1. ALL DIMENSIONS ARE TO FACE OF FRAMING.
2. CONTRACTOR TO VERIFY ALL EXISTING FIELD CONDITIONS PRIOR TO COMMENCING WORK.

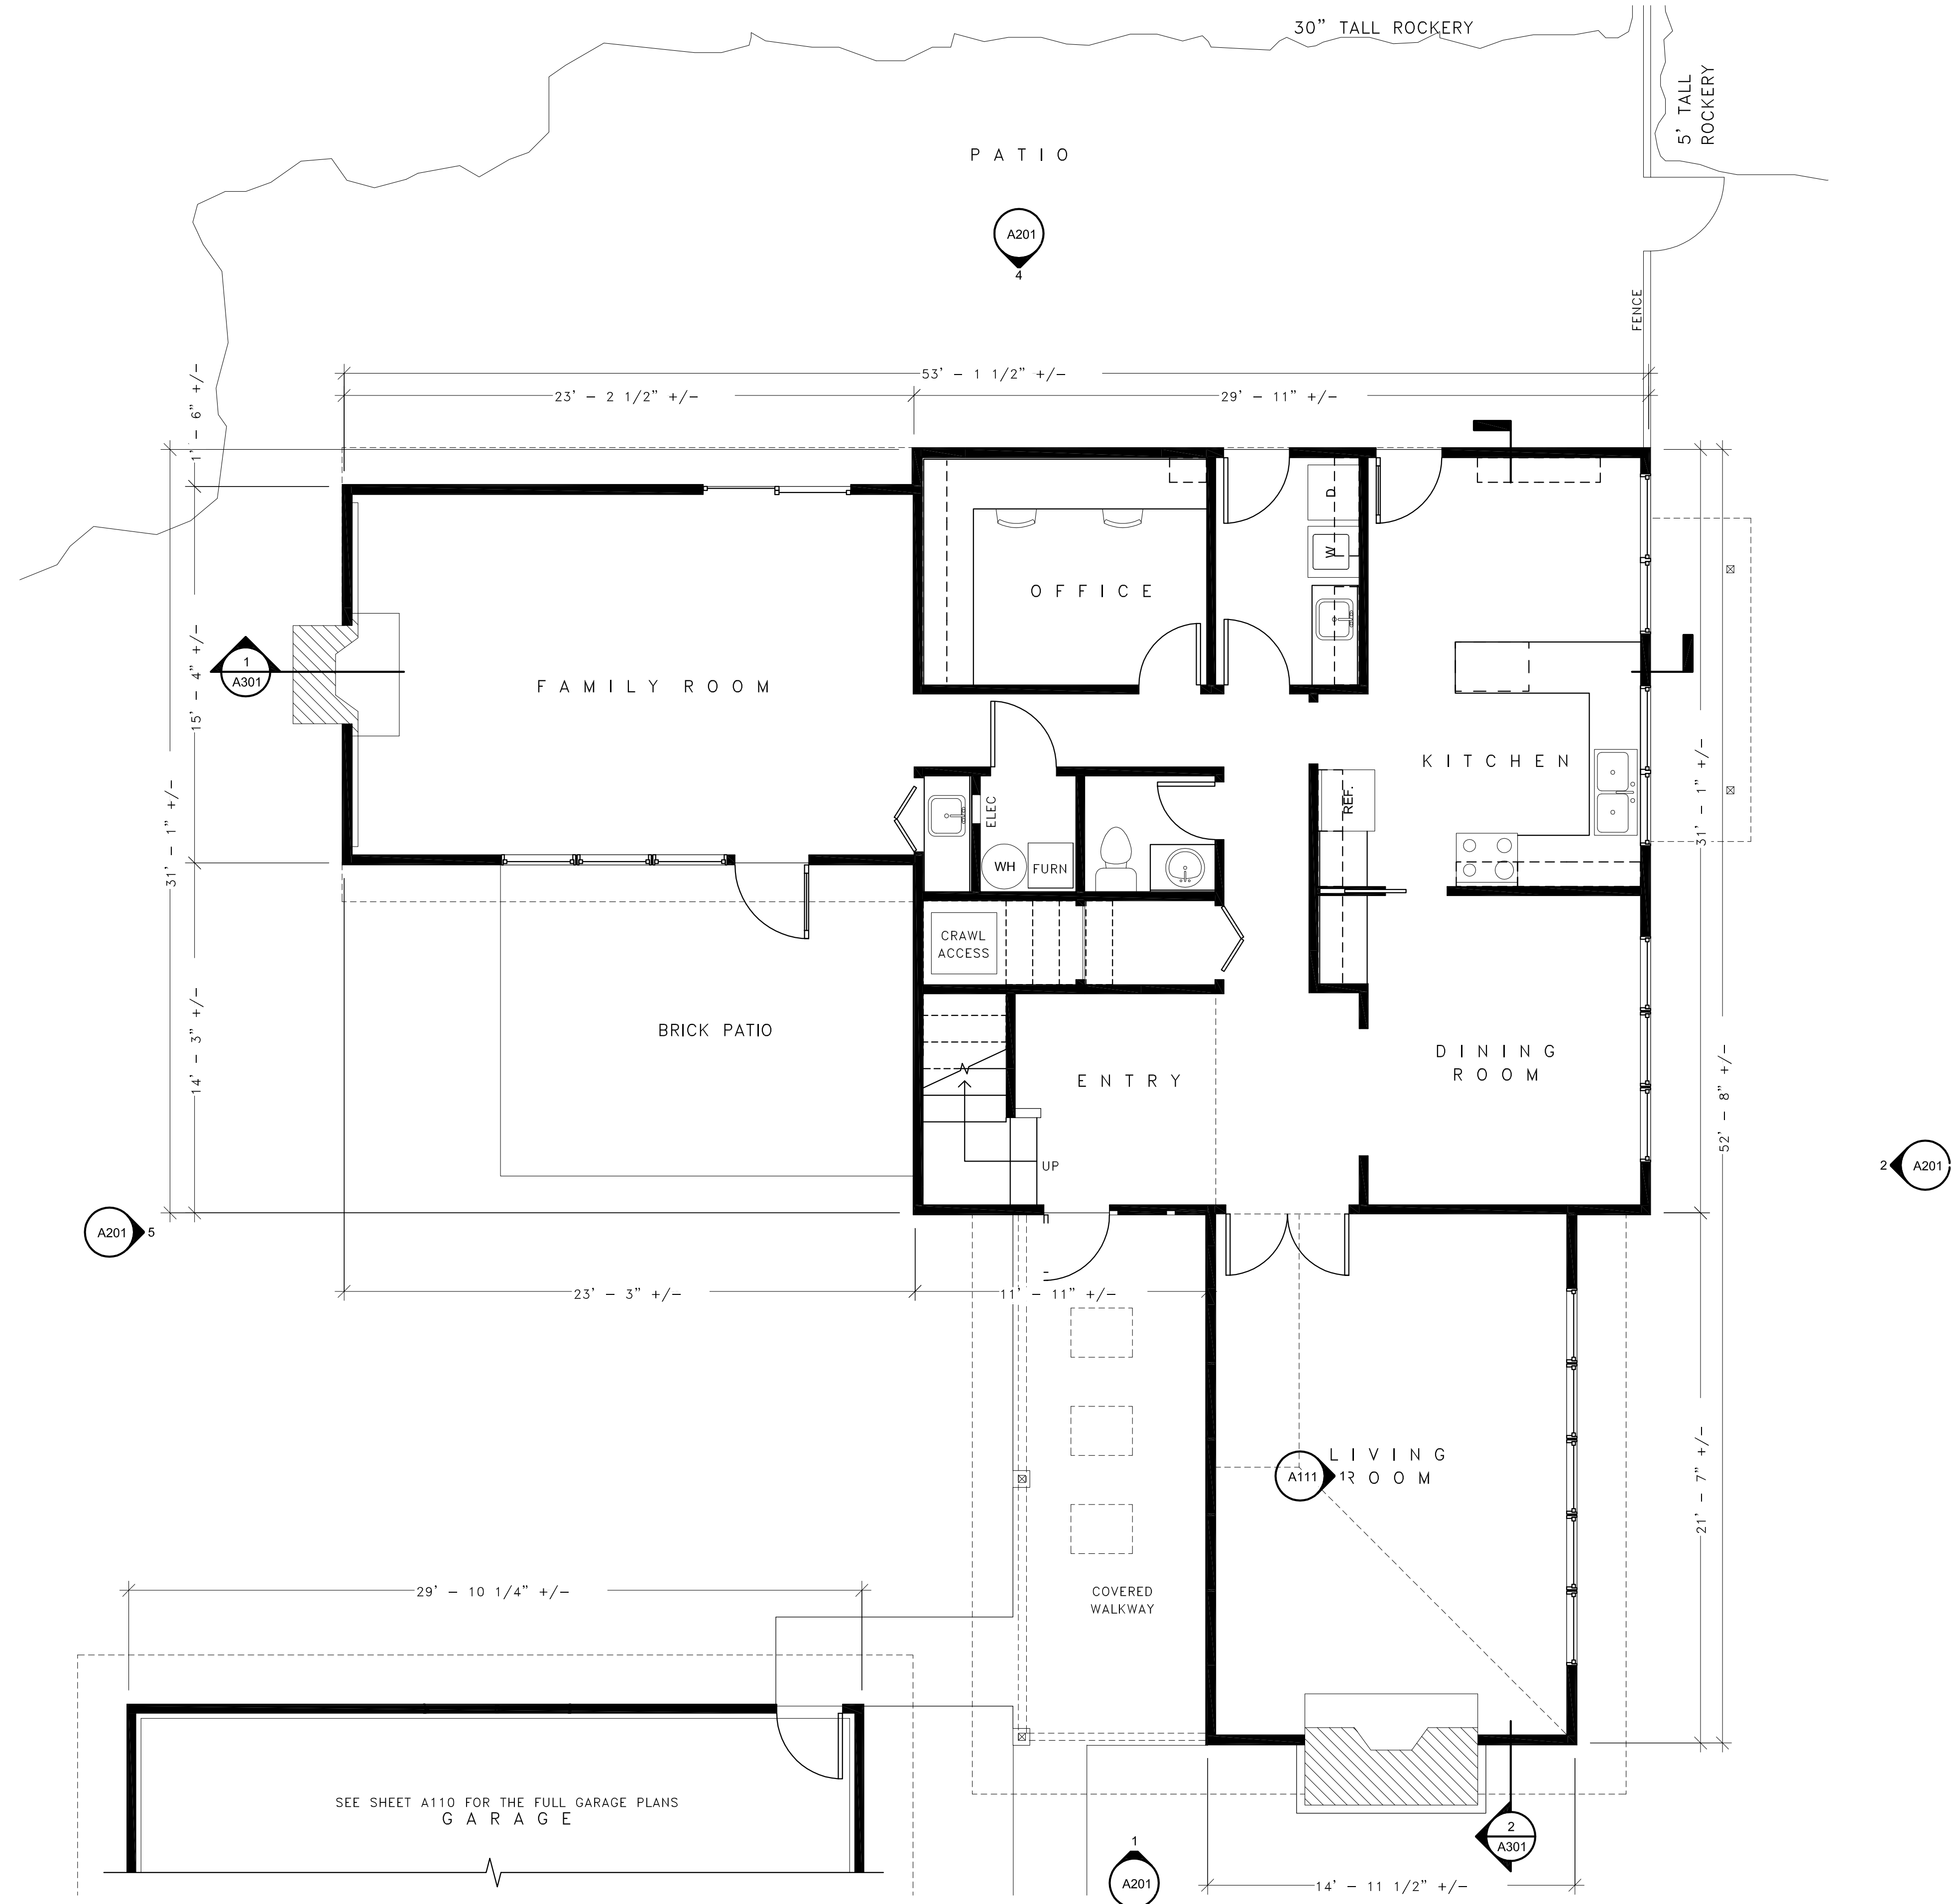


1 AS BUILT GROUND FLOOR PLAN
1/4" = 1'-0"

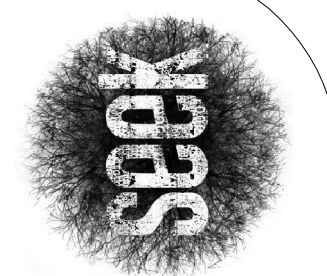

PREPARED BY:
SEEK ARCHITECTURE
ERIC BROOKS 425-681-1596

12/3/2015 1
SCHEMATIC

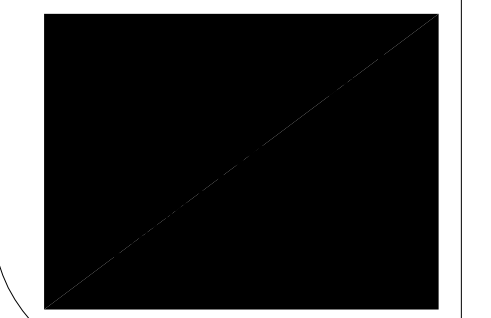

NOT FOR CONSTRUCTION
JURISDICTION APPROVAL SPACE

AS BUILT PLANS

HARNER-JAY RESIDENCE
8245 SE 59TH STREET
MERCER ISLAND, WA 98040